


PROPOSED

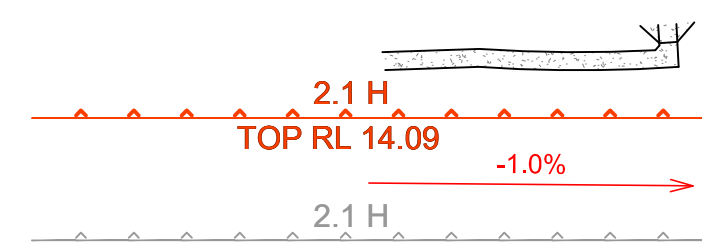


DESIGN CONTOUR MAJOR (0.5m INTERVAL)
DESIGN CONTOUR MINOR (0.1m INTERVAL)
KERB
FOOTPATH & PRAM RAMP
RETAINING WALL WITH HEIGHT & TOP OF WALL LEVEL
LOT CROSSFALL
STAGE 1 & 2 RETAINING WALL

SEE BULK EARTHWORKS PLAN SET FOR
LOT BENCHING DETAILS

NOTES:

- ALL RETAINING WALLS TO BE DESIGNED AND CERTIFIED BY A REGISTERED STRUCTURAL ENGINEER IN ACCORDANCE PMHC AUSPEC (CURRENT EDITION) AND RELEVANT AUSTRALIAN STANDARDS PRIOR TO CONSTRUCTION
- ALL FOOTINGS TO BE COMPLIANT WITH PMHC AUSPEC (CURRENT EDITION) D12.09
- RETAINING WALL PIERS TO BE A MINIMUM OF 600MM DISTANCE FROM SEWER INFRASTRUCTURE PIPELINES
- STRUCTURAL ENGINEER TO PROVIDE AS-BUILT CERTIFICATION AT COMPLETION OF WORKS

TYPICAL RETAINING WALL DETAIL (SUBJECT TO STRUCTURAL ENGINEER SPECIFICATION)

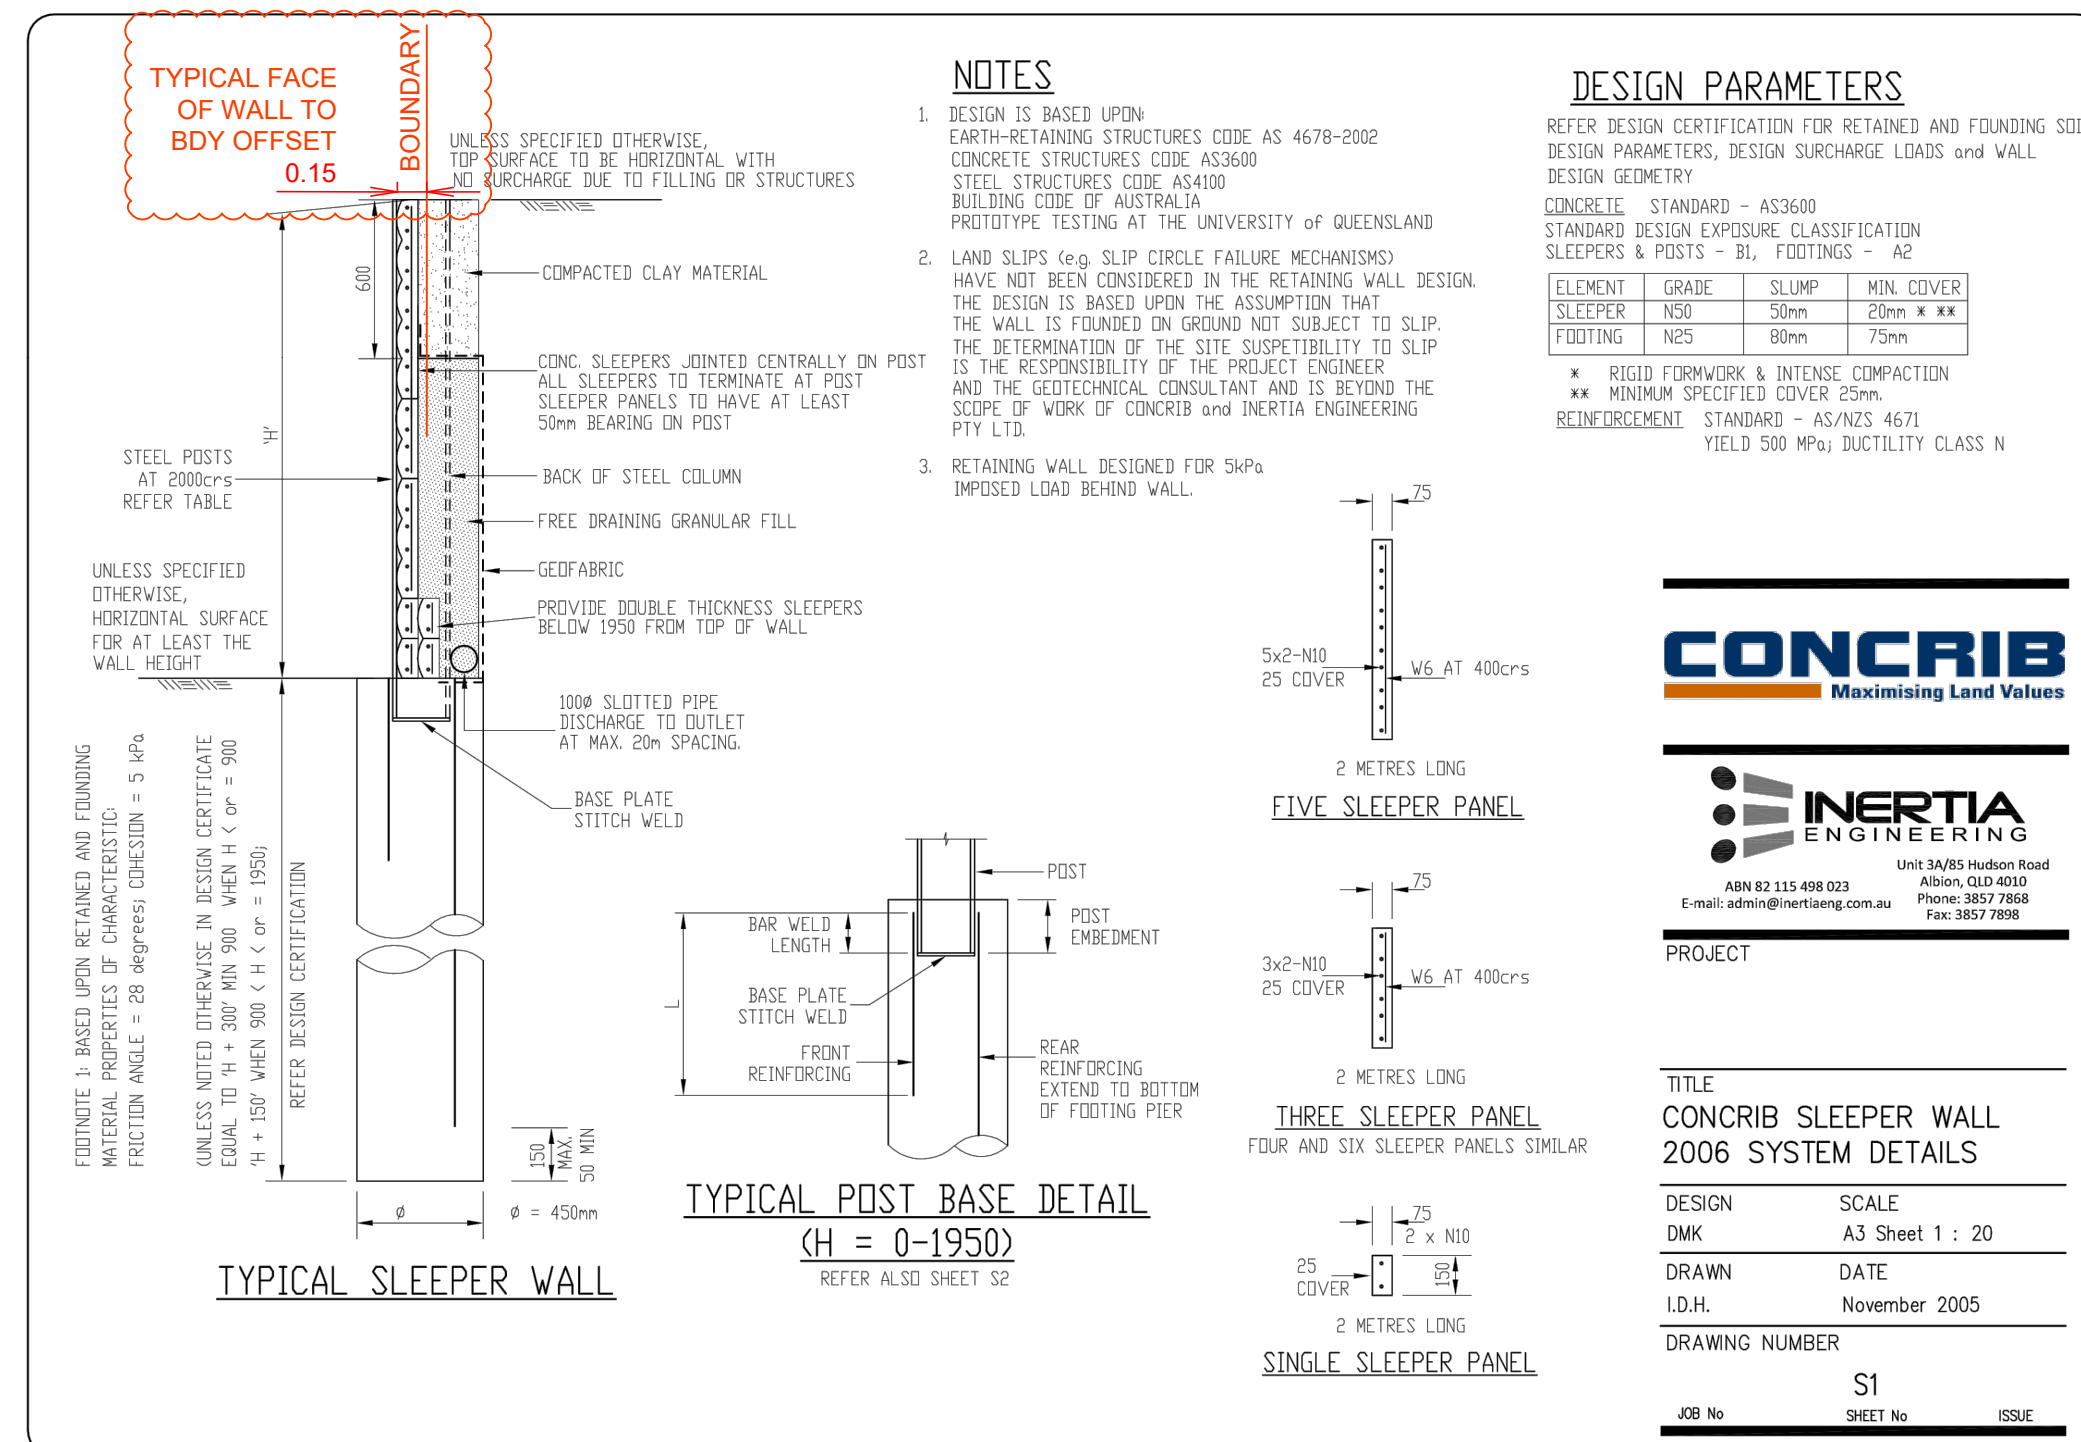


REV	DESCRIPTION	DATE	DRAWN	DESIGN	CHECK	APPROVED
A	STAGE 3 SUBDIVSION WORKS CERTIFICATE	21.06.21	A.C.	J.R.O.	M.S.	M.S.

SCALES:
 0 5 10 20 30
 Full Size 1:500 : Half Size 1:1000

DO NOT SCALE FROM DRAWING

Copyright of Land Dynamics Australia, No part of this drawing may be reproduced, stored in a retrieval system or transmitted in any form, without the written permission of the copyright owner except as permitted by the Copyright Act 1968.

Any permitted downloading, electronic storage, display, print, copy or reproduction of this drawing should contain no alteration or addition to the original drawing. This notice must not be erased.

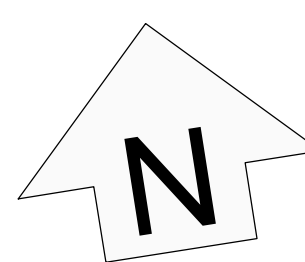

LandDynamics
AUSTRALIA

www.ldynamics.com.au 77 Lord St, Port Macquaire NSW 2444 PH:02 6583 2677



CONTACT DIAL BEFORE YOU DIG PRIOR
COMMENCING ANY EXCAVATION WORKS

PRELIMINARY ISSUE
NOT FOR CONSTRUCTION

NOTE:
LOCATION OF UNDERGROUND
SERVICES ARE APPROXIMATE
ONLY AND LAND DYNAMICS HOLDS
NO WARRANTY TO THE LOCATION
OF THE LINE WORK HEREIN

PROJECT:
THE SANCTUARY STAGE 3

DRAWING TITLE:
RETAINING WALL PLAN

ORIGINAL SIZE: A1	LAND DYNAMICS JOB No.: 5153	DRAWING No.: 1016	REV: A
-----------------------------	---------------------------------------	-----------------------------	------------------